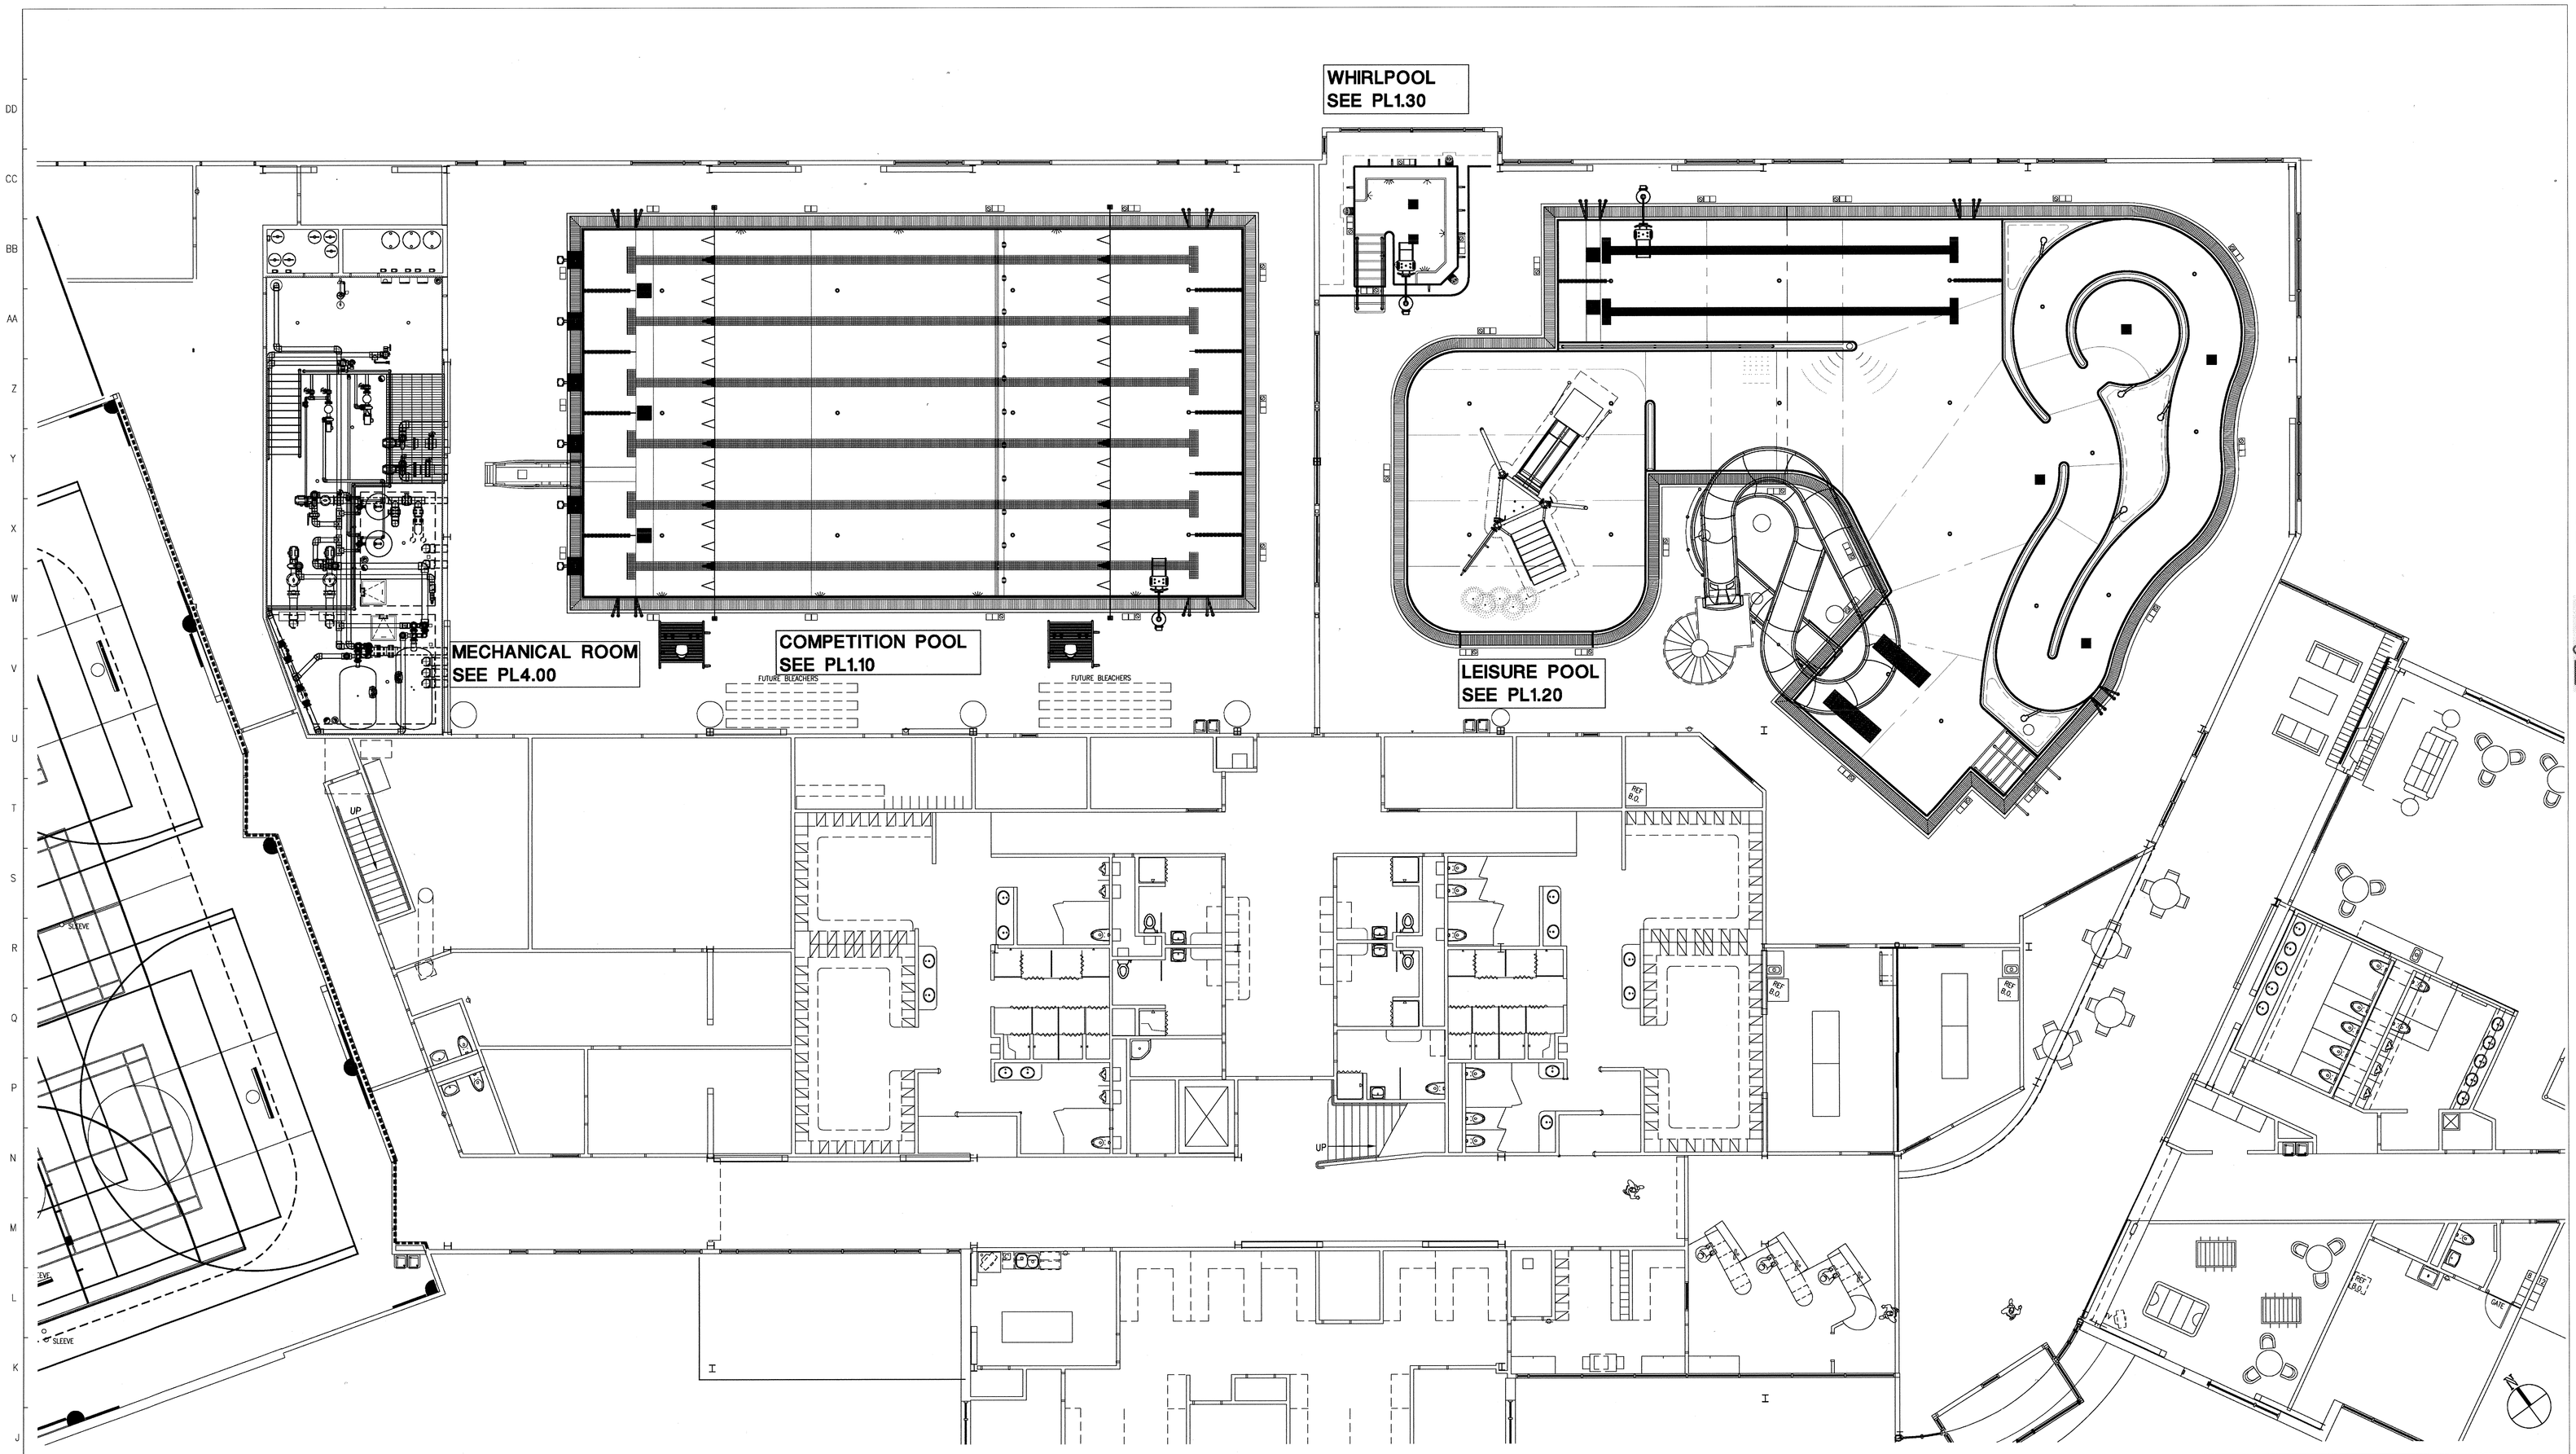

AQUATIC POOL PLAN

PL1.00-1

SCALE: 1/8" = 1'-0"

THIS SPACE NOT USED

PL1.00-6

SCALE: NONE

THIS SPACE NOT USED

PL1.00-5

SCALE: NONE

THIS SPACE NOT USED

PL1.00-4

SCALE: NONE

DEPTH MARKER - WALL

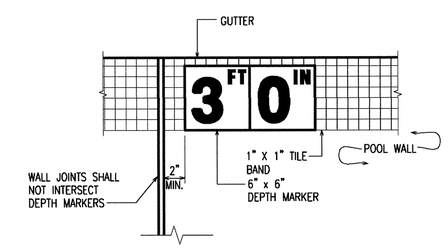

NOTES:

1. DEPTH SHALL BE VERIFIED BY SECTION 13150 CONTRACTOR AND MARKERS SHALL BE INSTALLED TO INDICATE ACTUAL DEPTH OF WATER.
2. DEPTH MARKERS SHALL BE SPACED AT NOT MORE THAN 25'-0" INTERVALS MEASURED PERIPHERALLY. REFER TO PLAN FOR APPROXIMATE LOCATION.
3. TILES SHALL BE RECESSED SO THAT THE FACE OF THE TILE IS FLUSH WITH FINISHED SURFACE.
4. DEPTH MARKERS SHALL BE 6"x6", WHITE, TILE W/ 4" HIGH BLACK NUMERALS.

PL1.00-3

SCALE: NONE

DEPTH MARKER - DECK

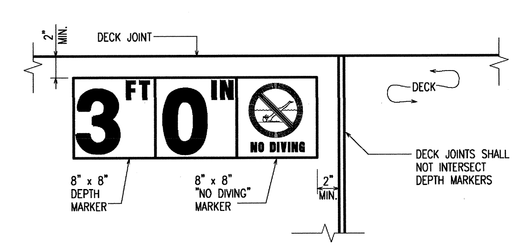

NOTES:

1. DEPTH SHALL BE VERIFIED BY SECTION 13150 CONTRACTOR AND MARKERS SHALL BE INSTALLED TO INDICATE ACTUAL DEPTH OF WATER.
2. DEPTH MARKERS SHALL BE SPACED AT NOT MORE THAN 25'-0" INTERVALS MEASURED PERIPHERALLY. REFER TO PLAN FOR APPROXIMATE LOCATION.
3. TILES SHALL BE RECESSED SO THAT THE FACE OF THE TILE IS FLUSH WITH FINISHED SURFACE.
4. DEPTH AND NO DIVING MARKERS SHALL BE 8"x8", WHITE, NON-SLIP TILE W/ 6" HIGH BLACK NUMERALS OR RED INTERNATIONAL NO DIVING SYMBOL.

PL1.00-2

SCALE: NONE

BARKER RINKER SEACAT
2300 Fifteenth Street, Suite 100
Denver, Colorado 80202
303-455-1366 Fax. 303-455-7457
http://www.brsarch.com

arai jackson ellison murakami LLP
ARCHITECTURE | URBAN DESIGN | INTERIORS

© Copyright WATER TECHNOLOGY, INC. 2005

WATER TECHNOLOGY, INC.
Aquatic Planning, Engineering & Design
Beaver Dam, WI • Chicago, IL
100 Park Avenue | PO Box 614 Beaver Dam, Wisconsin 53916
Voice 920.887.7373 FAX 920.887.7999

JOB #13022

CITY OF Federal Way

Federal Way Community Center

33190
9th Avenue South

AS-BUILTS

Drawn By: JVH
Checked By: JG
Date: 4 / 25 / 2005

Revision / Date:
PERMIT ISSUE 2/7/05
O.A. ISSUE 3/18/05
BID ISSUE 4/25/05

Sheet Title:
AQUATIC POOL PLANS & DETAILS

PL1.00

© 2004,2005 Barker Rinker Seacat Architecture