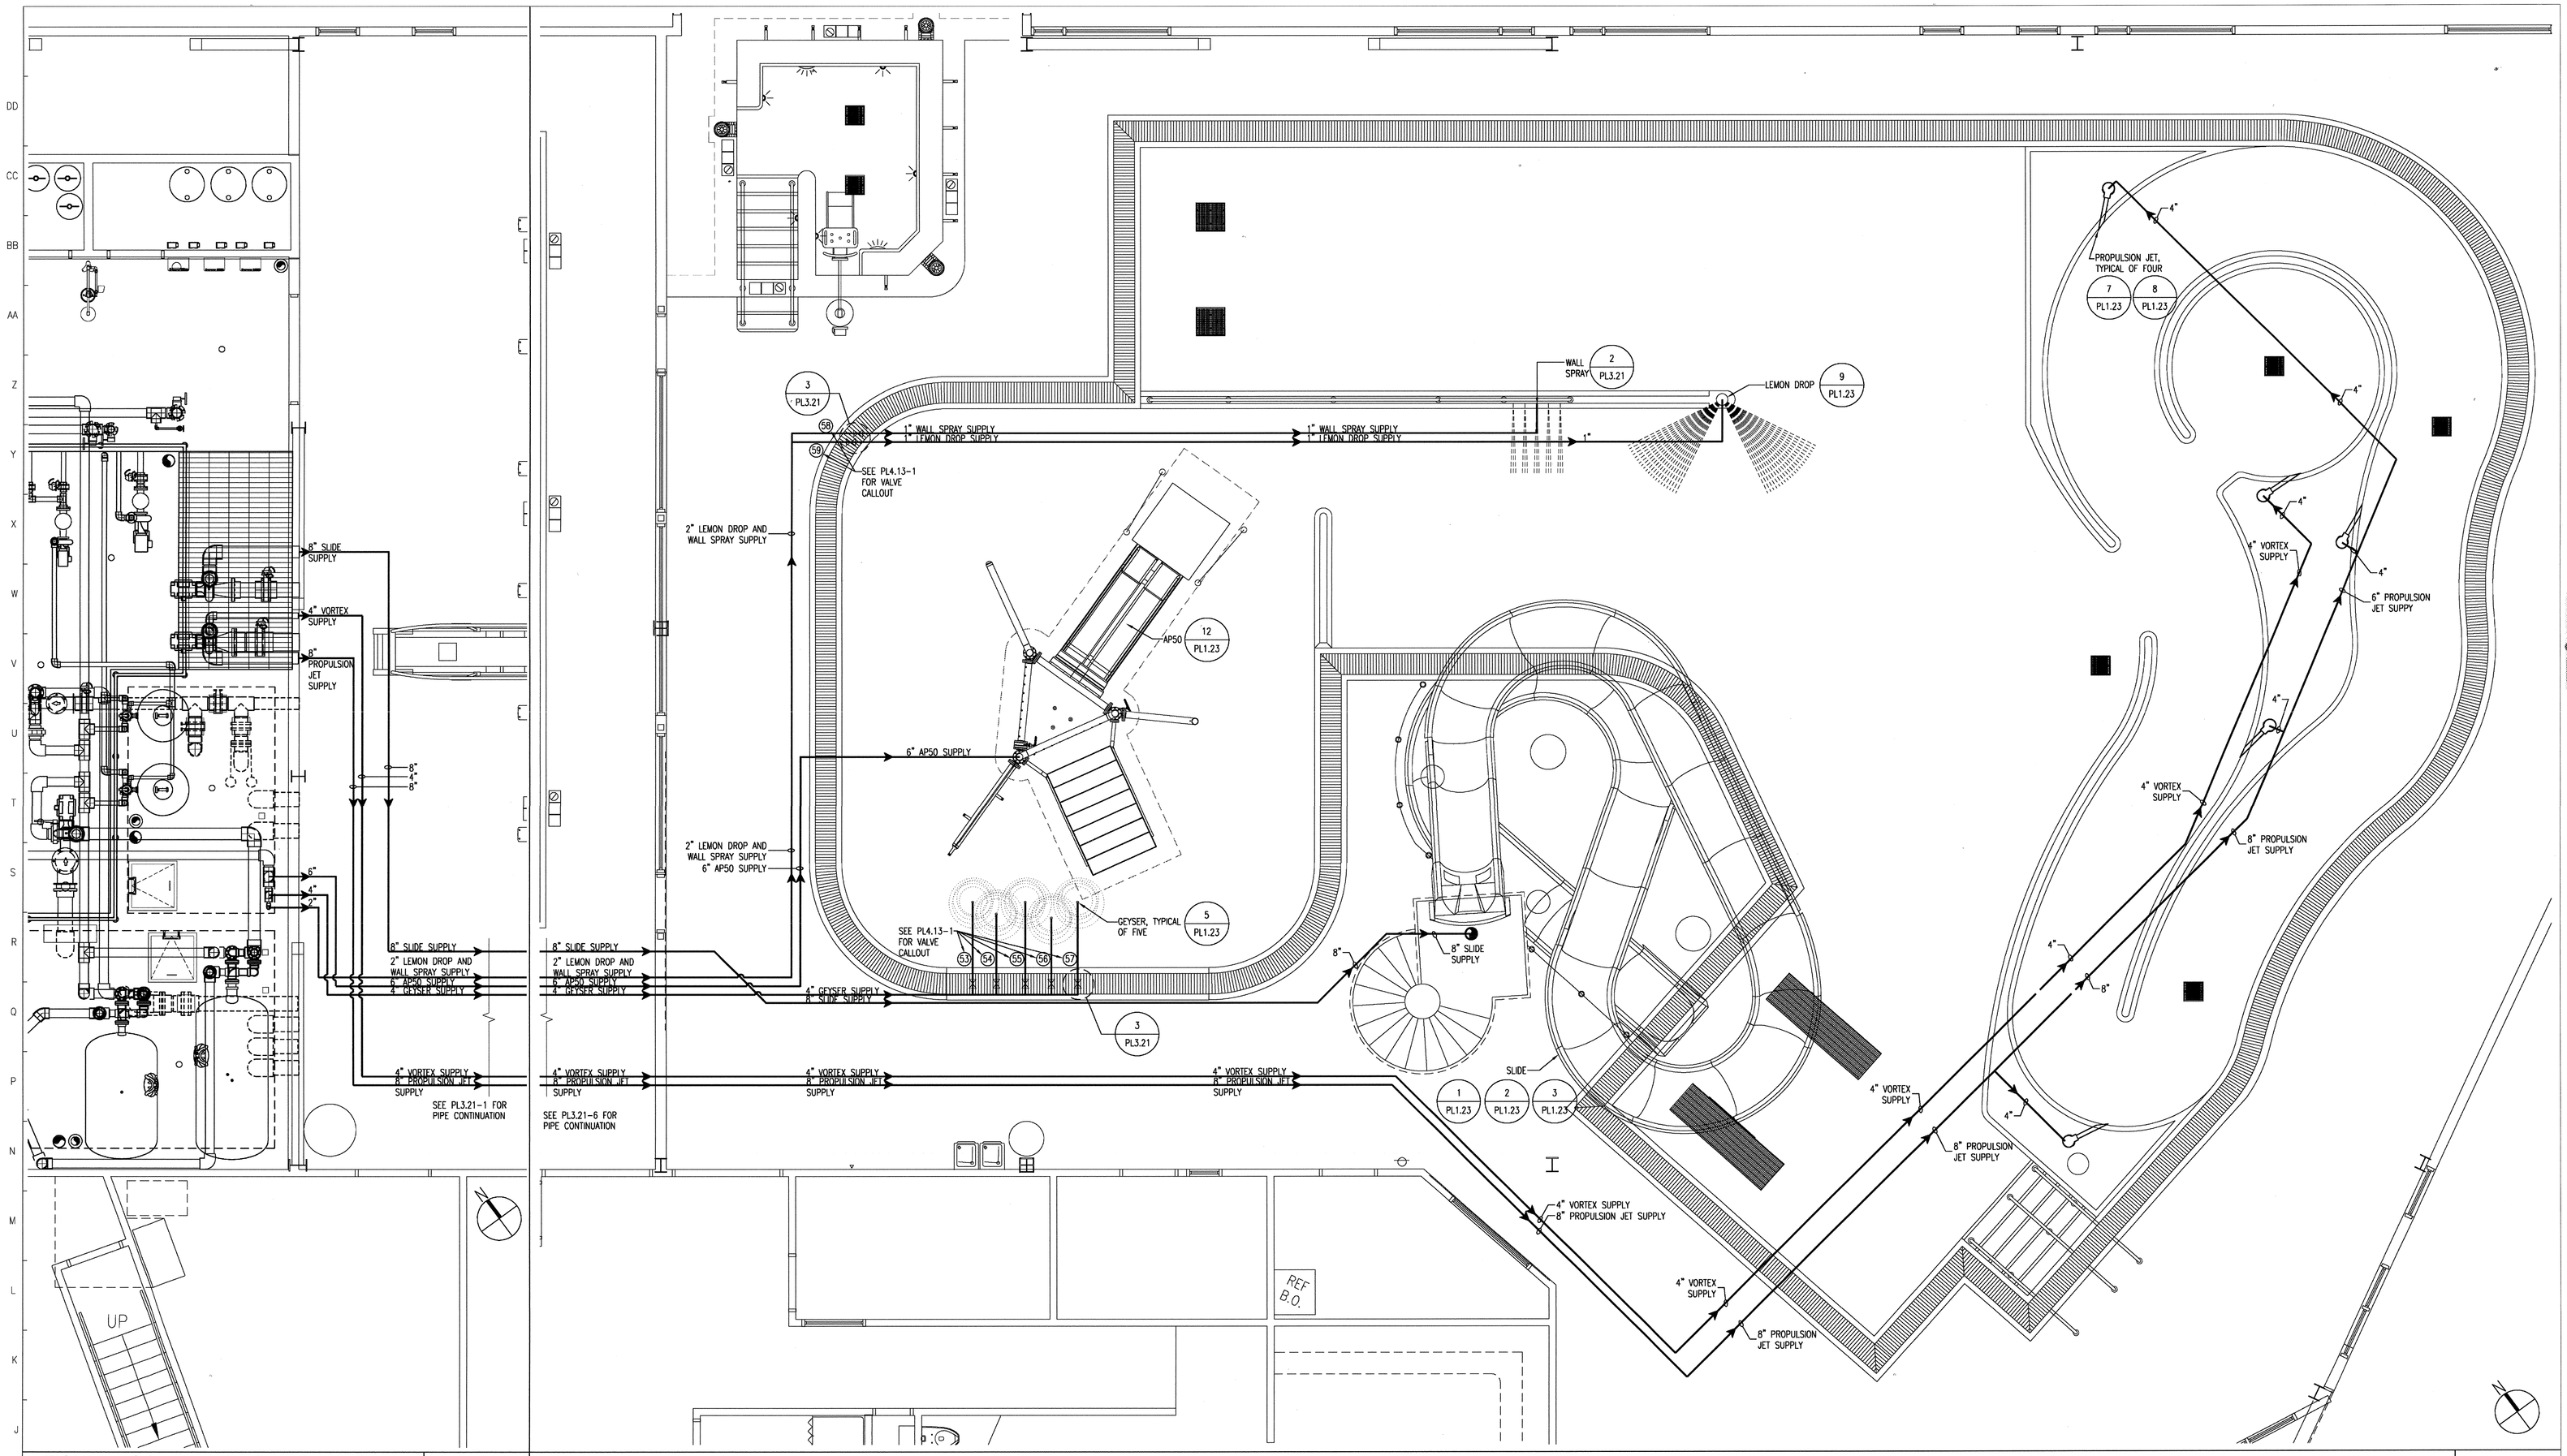

LEISURE POOL PIPING TO MECHANICAL ROOM | PL3.21-6 | SCALE: 1/4" = 1'-0"

LEISURE POOL ACTIVITY PIPING | PL3.21-1 | SCALE: 1/4" = 1'-0"

THIS SPACE NOT USED | PL3.21-7 | SCALE: NONE

THIS SPACE NOT USED | PL3.21-5 | SCALE: NONE

THIS SPACE NOT USED | PL3.21-4 | SCALE: NONE

ACTIVITY VALVE DETAIL | PL3.21-3 | SCALE: NONE

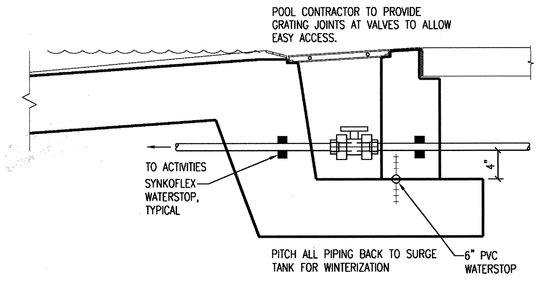

WALL SPRAY INSTALLATION DETAIL | PL3.21-2 | SCALE: NONE

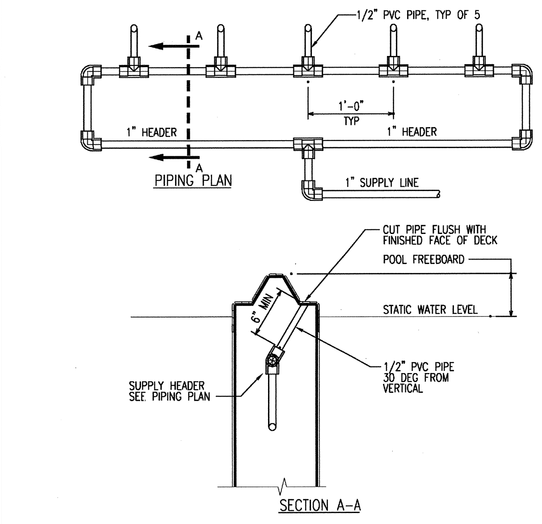

BARKER RINKER SEACAT
2300 Fifteenth Street, Suite 100
Denver, Colorado 80202
303-455-1366 Fax 303-455-7457
http://www.brsarch.com

arai jackson ellison murakami LLP
ARCHITECTURE | URBAN DESIGN | INTERIORS

© Copyright WATER TECHNOLOGY, INC. 2003

WATER TECHNOLOGY, INC.
Aquatic Recreation Consultants
Beaver Dam, WI • Chicago, IL
100 Park Avenue | PO Box 614 Beaver Dam, Wisconsin 53916
Voice 920.887.7375 FAX 920.887.7699

JOB #23022

CITY OF Federal Way

Federal Way Community Center

33190
9th Avenue South

AS-BUILTS

Drawn By: JVH
Checked By: JG
Date: 4 / 25 / 2005

Revision / Date:
PERMIT ISSUE 2/7/05
Q.A. ISSUE 3/18/05
BID ISSUE 4/25/05

Sheet Title:
LEISURE POOL ACTIVITY PIPING PLAN VIEW

PL3.21

© 2004,2005 Barker Rinker Seacat Architecture